


Gym ~ Package H
Flr Cellar
Quantity: (1)
Ceiling Ht 102"

Red Star Cabinet Co Inc 226 Sherwood Avenue, Suite A Farmingdale, New York 11735 631 694 6200	Customer: The Rinaldi Group Project: 75 Kenmare Street Title: Gym Pantry - Cellar : Plan View Date: 10-26-18 Scale: NONE		No:	Date:	Revisions:	By:
	Dwg # RS -1801 Gym					

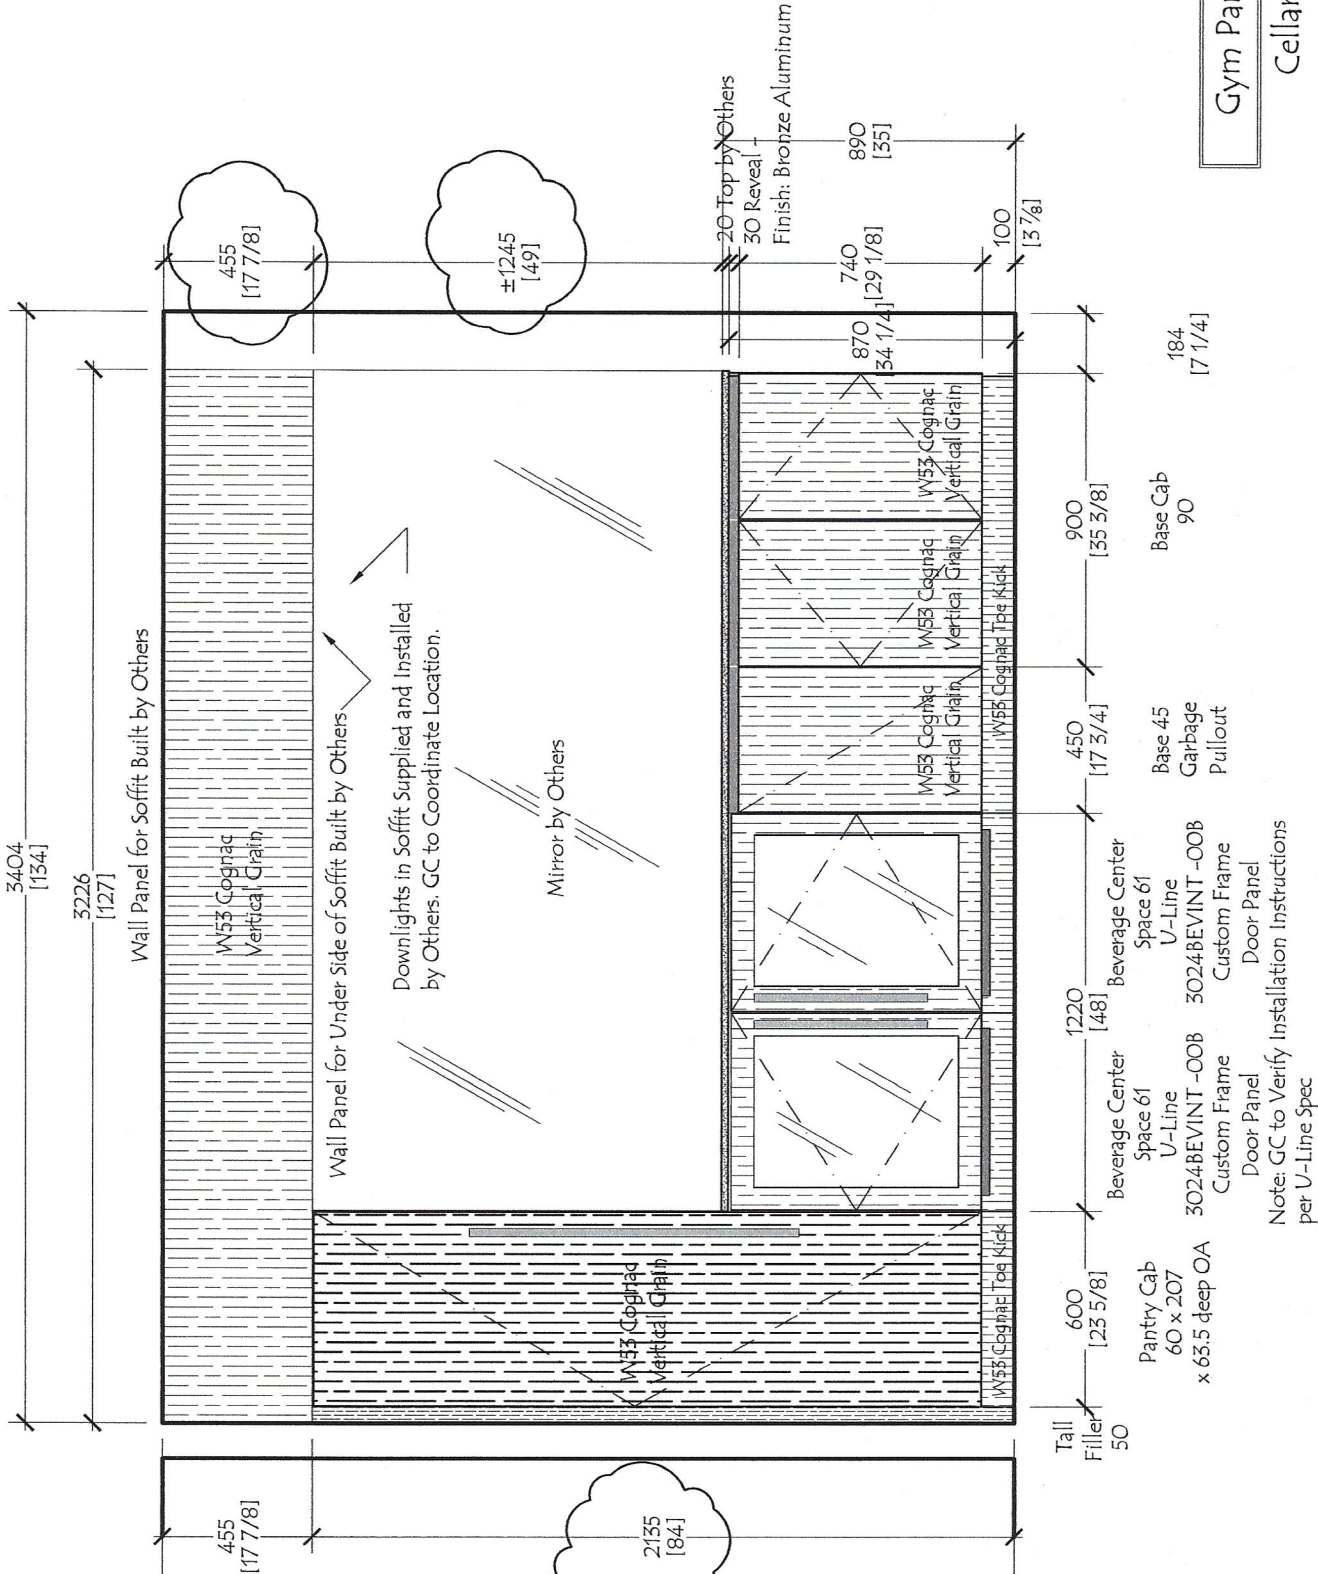

Gym Pantry

Cellar


Dwg # RS -1801
Gym 1

No:	Date:	Revisions:	By:

Customer:	The Rinaldi Group
Project:	75 Kenmare Street
Title:	Gym Pantry - Cellar: Elevation 1
Date:	10-26-18
Scale:	NONE

Red Star Cabinet Co Inc
 226 Sherwood Avenue, Suite A
 Farmingdale, New York 11735
 631 694 6200

Wall Panel
for Soffit
Built by Others

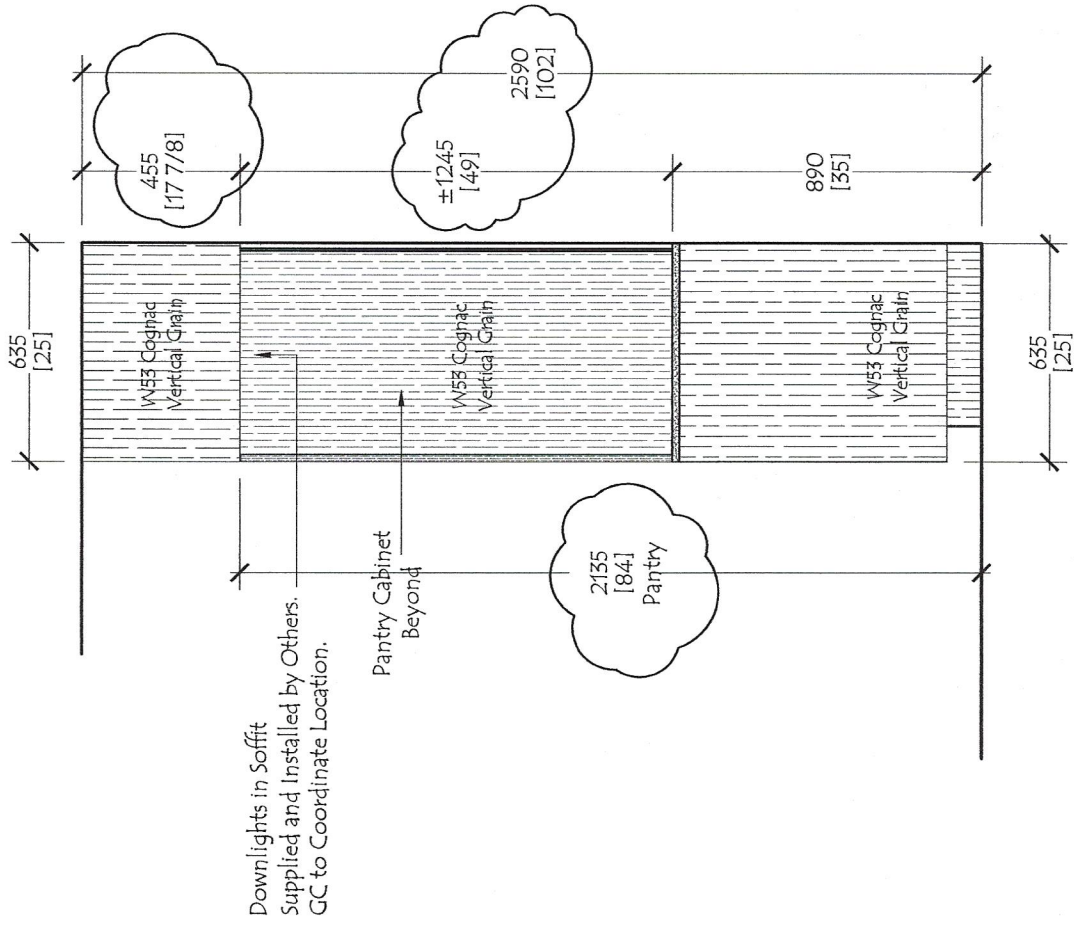


Gym Pantry
Cellar

Dwg #
RS -1801
Gym 2

No:	Date:	Revisions:	By:

Customer: The Rinaldi Group
 Project: 75 Kenmare Street
 Title: Gym Pantry - Cellar: Elevation 2
 Date: 10-26-18 Scale: NONE


Red Star Cabinet Co Inc
 226 Sherwood Avenue, Suite A
 Farmingdale, New York 11735
 631 694 6200

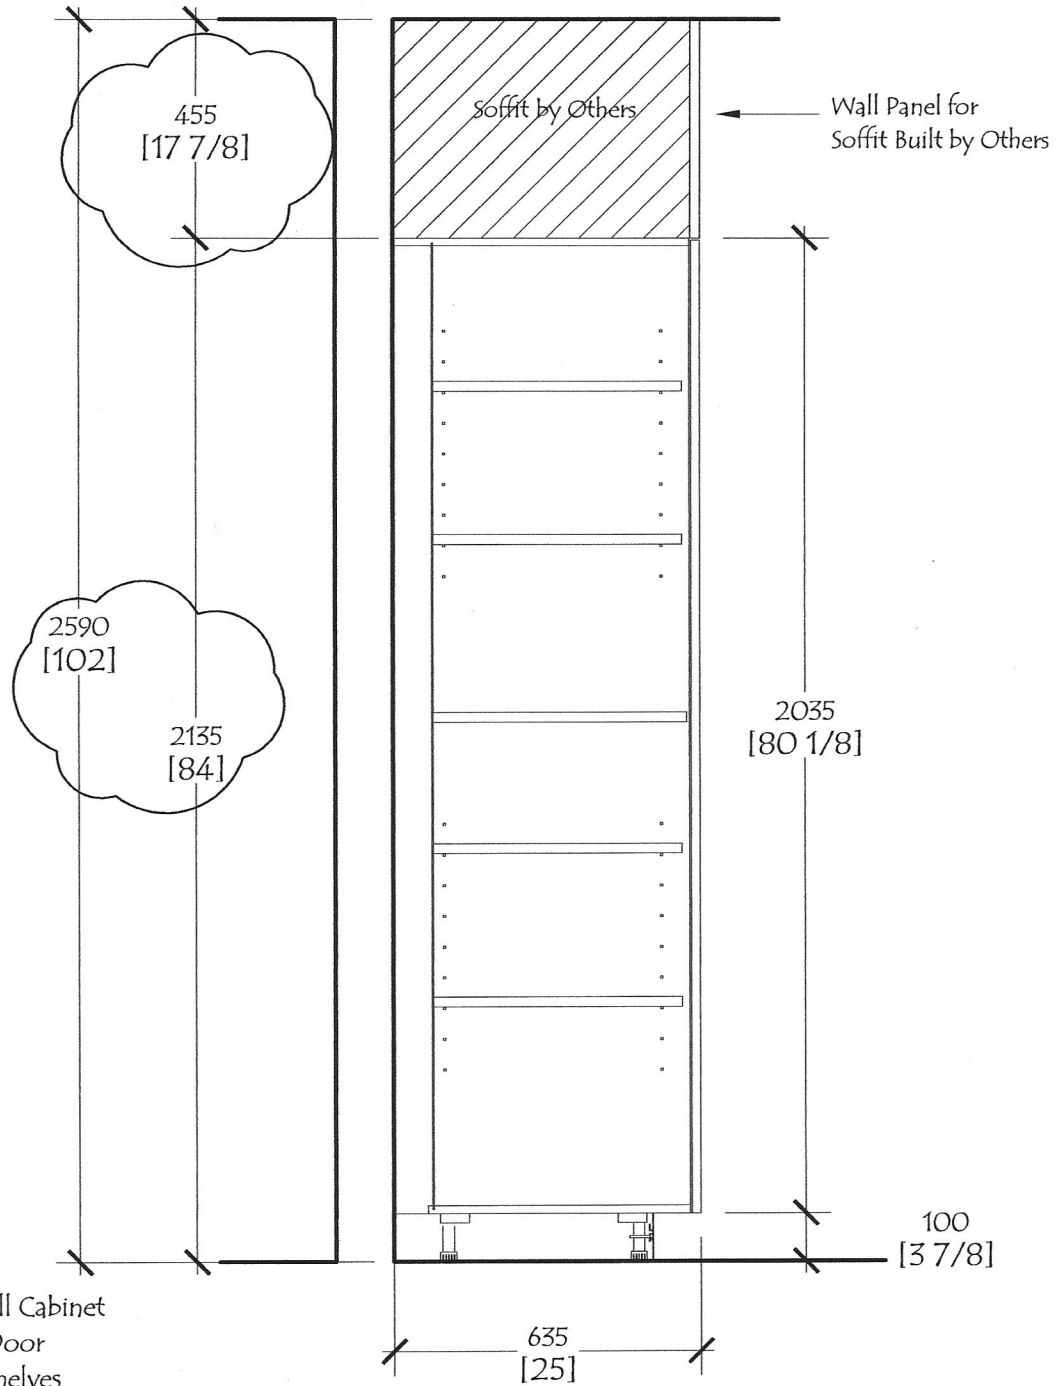

Section at Tall Cabinet
 Full Height Door
 Adjustable Shelves
 Floor Cellar
 Ceiling Height 102"

Section 1


CUSTOMER :	The Rinaldi Group	NO.	DATE	REVISIONS	BY	DWG. # RS 1801 Gym Sect 1
PROJECT :	75 Kenmare Street					
TITLE :	Gym Pantry - Cellar: Section 1					
DATE :	10-26-18	SCALE :	NONE	DRAWN BY :	CHECKED BY :	

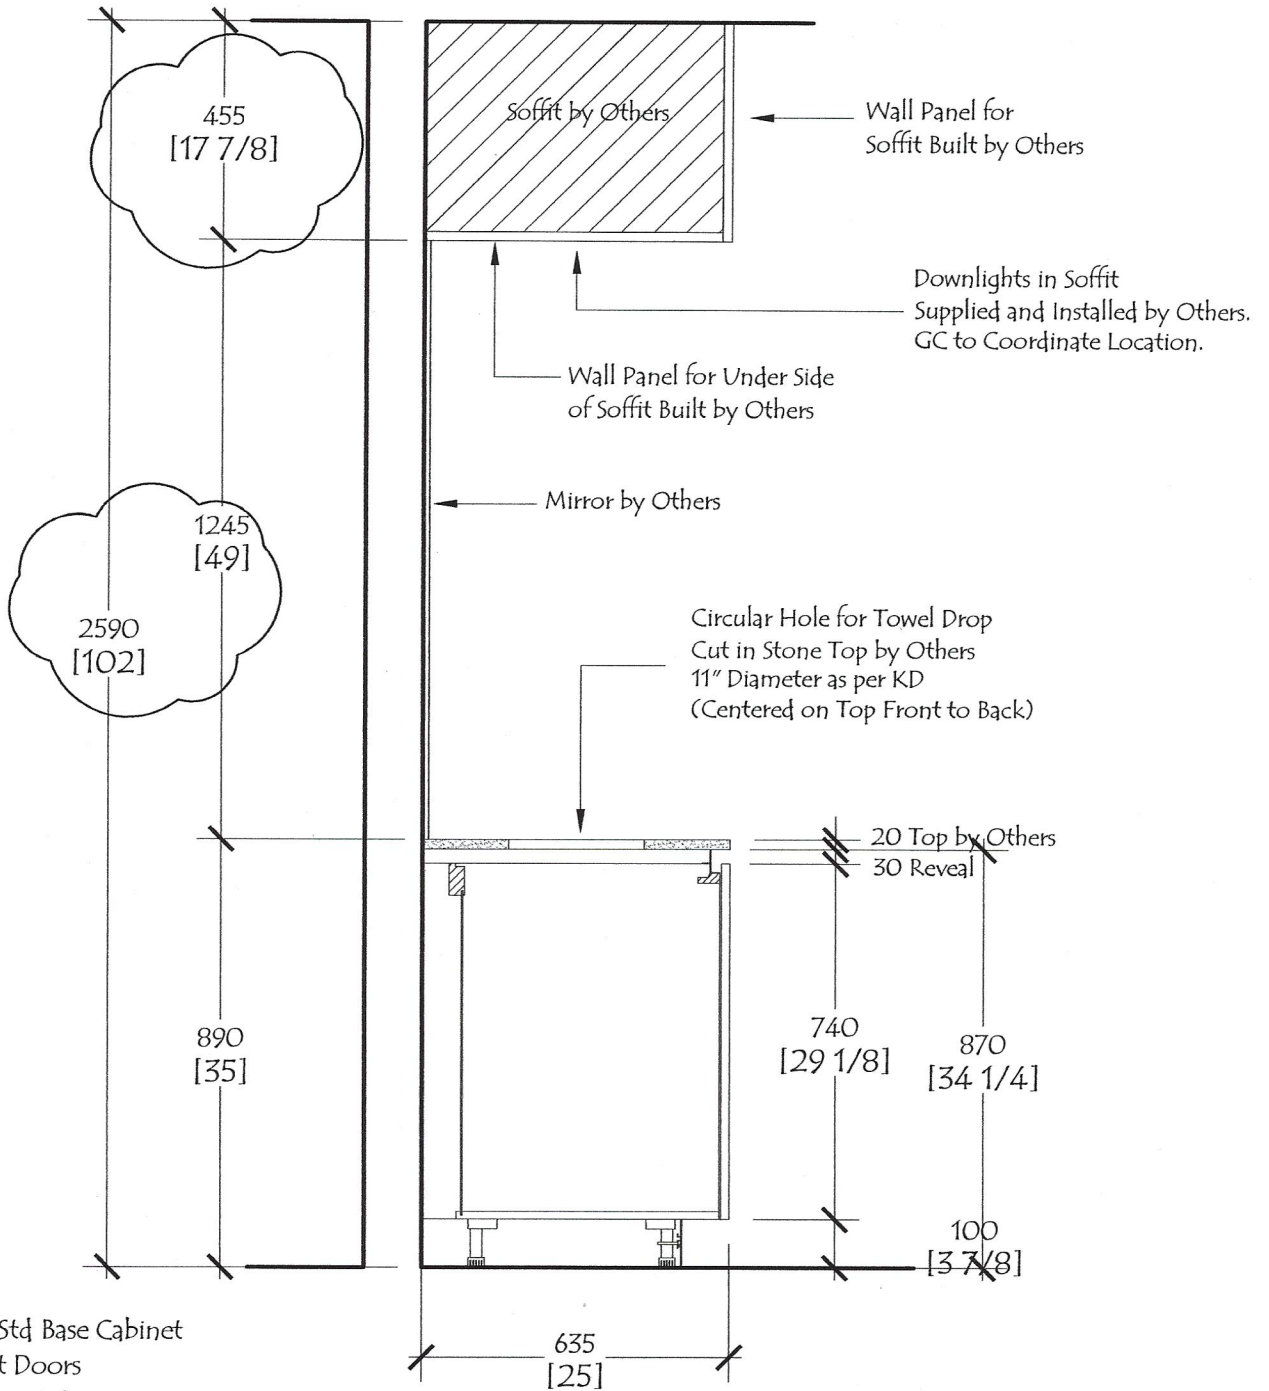

Section at Std Base Cabinet
Full Height Doors
Floor: Cellar at Gym
Ceiling Height 102"


Section 2

CUSTOMER:	The Rinaldi Group	NO.	DATE	REVISIONS	BY	DWG. #
PROJECT:	75 Kenmare Street					RS 1801
TITLE:	Gym Pantry - Cellar: Section 2					Gym
DATE:	10-26-18	SCALE:	NONE	DRAWN BY:	CHECKED BY:	Sect 2

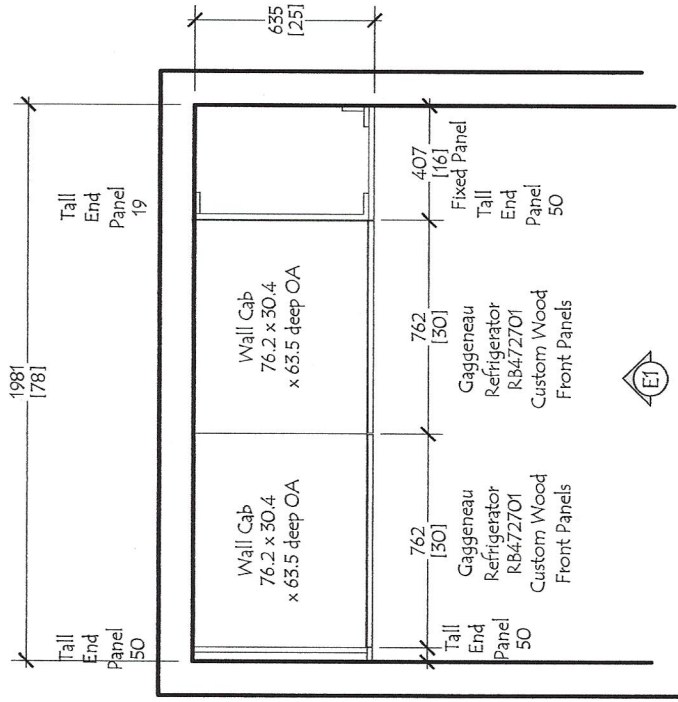

Package Room - Package G
 Flr 1 (Ground)
 Quantity: (1)
 Ceiling Ht 96"

Red Star Cabinet Co Inc 226 Sherwood Avenue, Suite A Farmingdale, New York 11735 631 694 6200		Customer: The Rinaldi Group		Dwg #	
Project: 75 Kenmare Street		By:		RS -1801	
Title: Kitchen - Plan View - Package Room		Revisions:		Pkg Rm	
Date: 10-26-18		Date:		No:	
Scale: NONE		No:		Date:	
		Revisions:		By:	

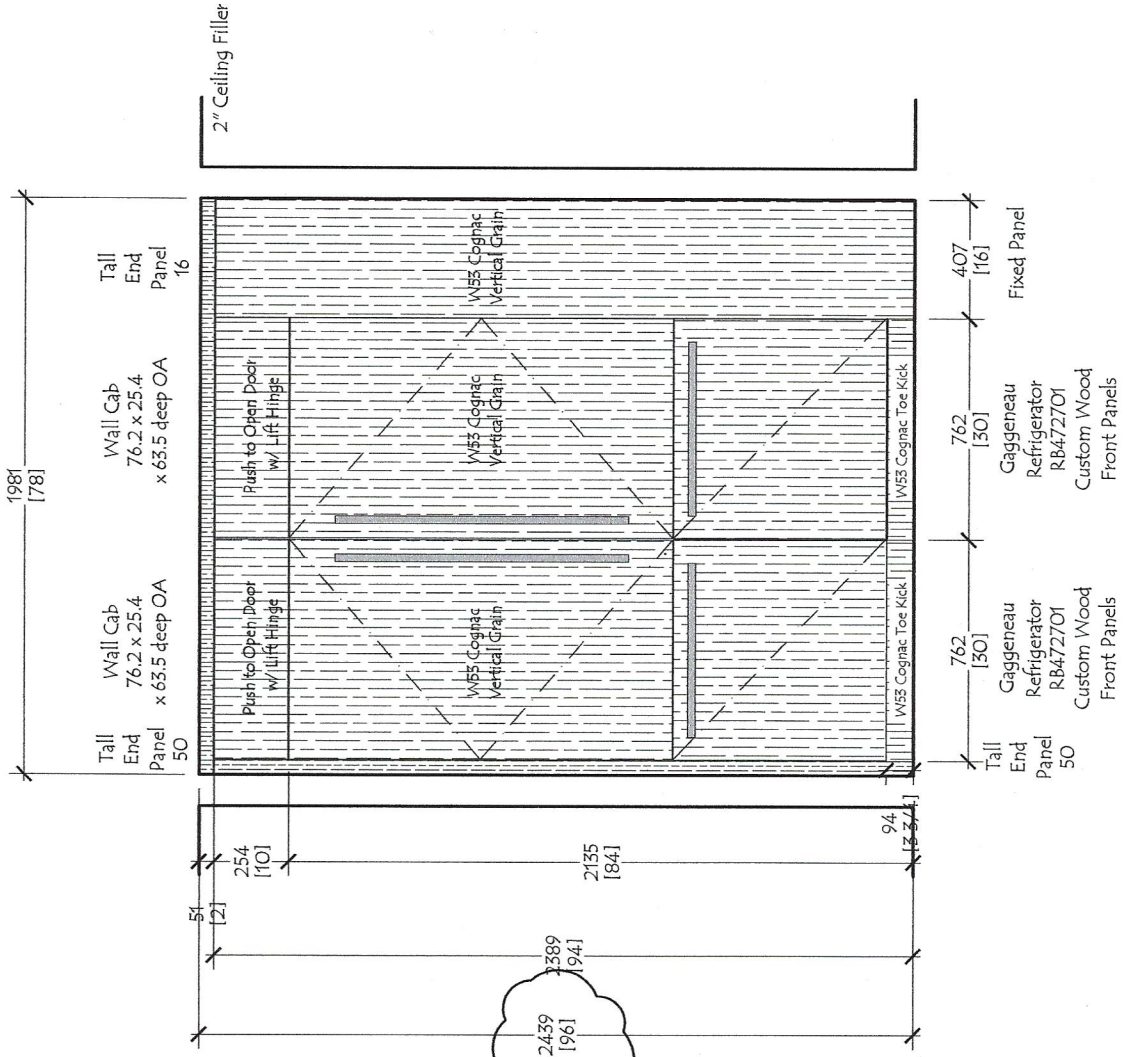

Package Room
Ground Floor

Dwg #
RS -1801
Pkg Rm 1

No:	Date:	Revisions:	By:

Customer: The Rinaldi Group
 Project: 75 Kenmare Street
 Title: Kitchen - Package Room - Elevation 1
 Date: 10-26-18 Scale: NONE

Red Star Cabinet Co Inc
 226 Sherwood Avenue, Suite A
 Farmingdale, New York 11735
 631 694 6200